



ADDENDUM #2
ITB/RFP NUMBER: 2016045-FD-B
Harrisonburg Fire Station #1 Renovations ITB

DATE: June 3, 2016

TO: All Potential Bidders/Offerors

City of Harrisonburg's Fire Station #1 Renovations ITB, is modified as follows:

1. Question: The following question concerns Specifications Section (number) 105113.16. Please provide plans for the Metal Gear and Turnout Lockers.

Answer: **Refer to Addendum No. 2, dated June 3, 2016.**

2. Question: The following question concerns Specifications Section (number) 097716. Please provide elevations for 102 Corridor, 105 Mailboxes, and 221 Corridor to show the extend of the FRP panels and chair rail.

Answer: **Refer to Drawing A2.1.**

3. Question: The following question concerns Specification Section (number) 088300. Please provide elevation of the west wall in room 223 indicating location and quantity of mirrors.

Answer: **Refer to Addendum No. 2, dated June 3, 2016.**

All other requirements, terms and conditions of the ITB/RFP remain unchanged.

Addendum page must be signed and returned with your bid/proposal to acknowledge receipt of this addendum.

Authorized Signature

By: Pat Hilliard, CPPB
Procurement Manager

1 **GENERAL:**

2 Planholders are requested to attach this Addendum to the inside front cover of each Project Book.
3 Inform all concerned that the Bidding Documents are modified by this Addendum.

4 The following modifications and clarifications are hereby made a part of the Bidding Documents and
5 supersede or otherwise modify the provisions of the published *Specifications*, and *Drawings*, dated
6 March 4, 2016.

7 Refer to the Drawings and Specification Sections, if any, attached to this Addendum, which are
8 hereby made a part of this Addendum.

9 **MODIFICATIONS TO THE DRAWINGS:**

10 **DRAWING A2.1**

11 SECOND FLOOR PLAN: In dimension string along west wall of Exercise Room, space 223,
12 **DELETE** 25'-0" MIRRORS THIS WALL" and **SUBSTITUTE** "(5) MIRRORS THIS WALL".



13 FIRST FLOOR PLAN: **ADD** lockers and Keynote 10 TO South Apparatus Bays, space 111.

14 FLOOR PLAN KEYNOTES: At keynote 6, **DELETE** "5' FRAMELESS MIRRORS." and
15 **SUBSTITUTE** "5'-0" X 5'-0" FRAMELESS MIRRORS". **ADD** keynote 10, "(35) 18" x 18"
16 TURN OUT GEAR LOCKERS. COORDINATE EXACT LOCATION W/ OWNER.

17 Refer to attached drawing AD2-A1.



18 **REFER TO DRAWINGS ATTACHED TO THE END OF THIS ADDENDUM**

19 **END OF ADDENDUM NO 2**

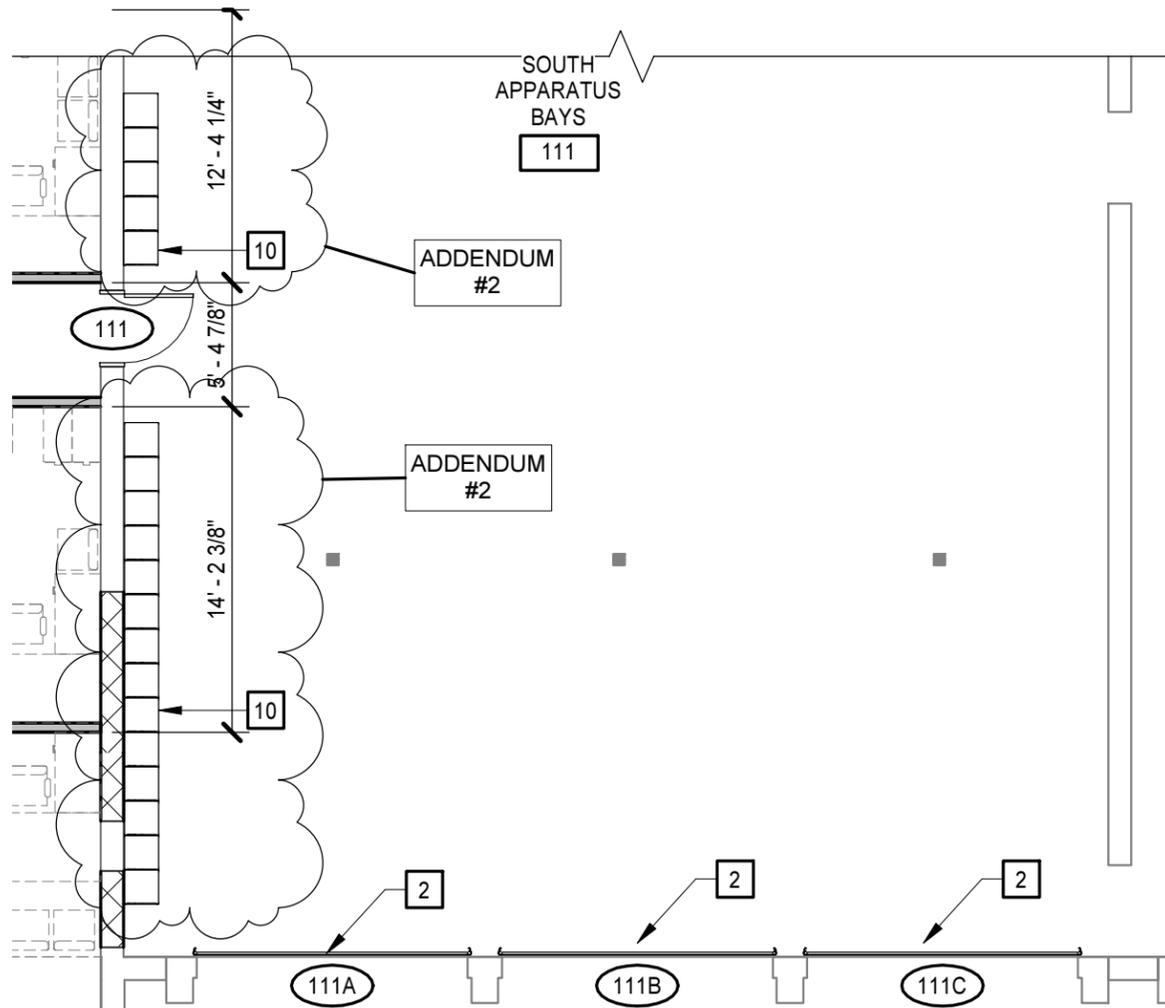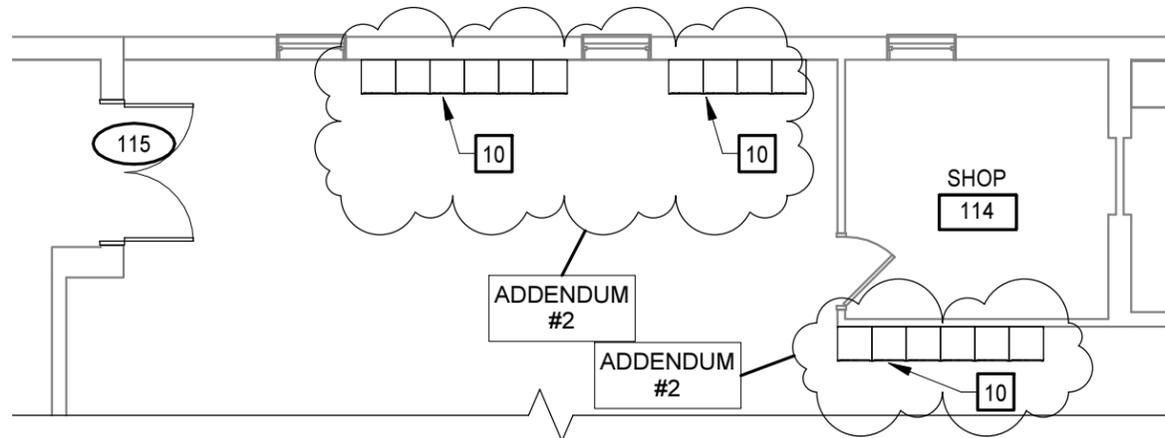

FIRST FLOOR PLAN

1/8" = 1'-0"

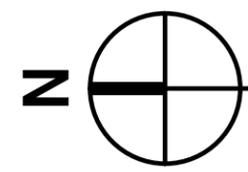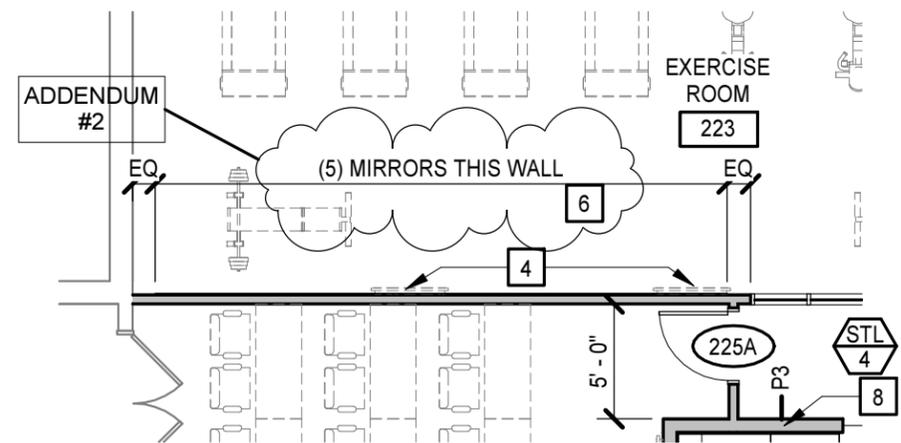

SECOND FLOOR PLAN

1/8" = 1'-0"

FLOOR PLAN KEYNOTES

APPLIES TO DRAWINGS A2.1 - A2.n

REPRESENTED BY [n]

- 1. SLIDE POLE, EXISTING TO REMAIN
- 2. APPARATUS BAY DOOR, EXISTING TO BE REPLACED
- 3. VENDING MACHINE. RELOCATE FROM EXISTING STAIR.
- 4. TV (NIC)
- 5. SMART BOARD. RELOCATE FROM EXISTING TRAINING ROOM.
- 6. 5'-0" X 5'-0" FRAMELESS MIRRORS. MOUNT TOP @ 7'-0".
- 7. LOUNGE CHAIRS, TYP (NIC)
- 8. PARTITION TO EXTEND 7'-6" AFF. TERMINATE WITH WOOD CAP. REFER TO 11/A8.1.
- 9. PRE-MANUFACTURED LADDER TO ROOF ACCESS HATCH.
- 10. (35) 18" X 18" TURN OUT GEAR LOCKERS. COORDINATE EXACT LOCATION W/ OWNER.

ADDENDUM #2

ADDENDUM #2

6/3/2016 8:15:13 AM

MOSELEYARCHITECTS
 3200 NORFOLK STREET, RICHMOND, VIRGINIA, 23230
 PHONE (804) 794-7555 FAX (804) 355-5690
 MOSELEYARCHITECTS.COM

DRAWING TITLE:
FLOOR PLAN CLARIFICATIONS

CONTRACT DWG NO.:
A2.1

PROJECT:
HARRISONBURG FIRE STATION #1
80 MARYLAND AVE, HARRISONBURG, VIRGINIA 22801

DRAWN BY:
CJR

DATE:
06/03/16

ATTACHMENT TO:
ADDENDUM #2

PROJECT NO:
550358

SUPPLEMENTAL DWG. NO:
AD2-A1